
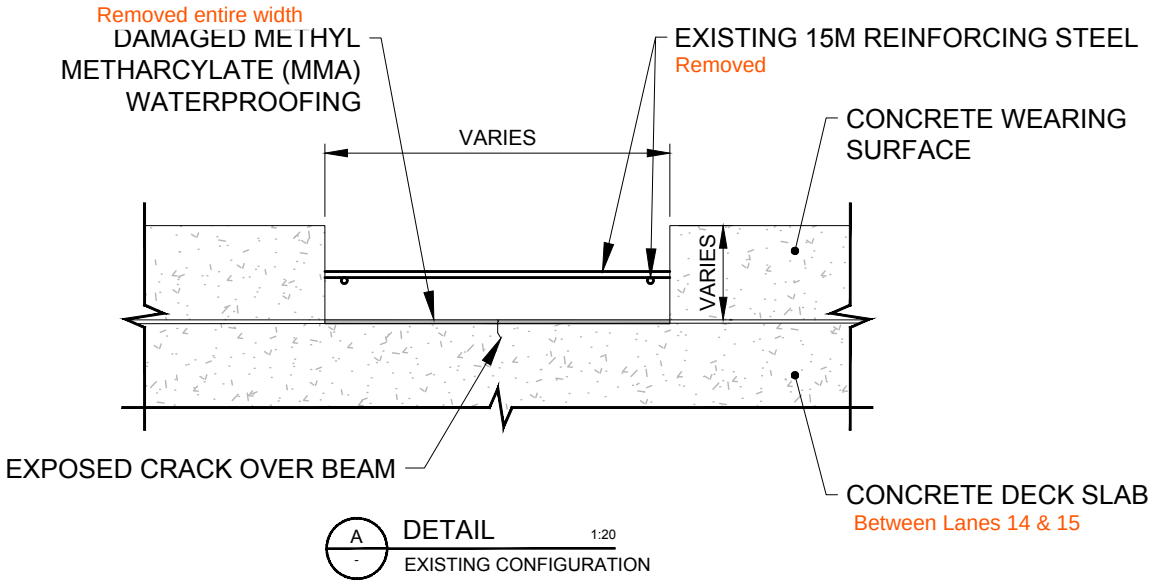


A - DETAIL 1:20
EXISTING CONFIGURATION

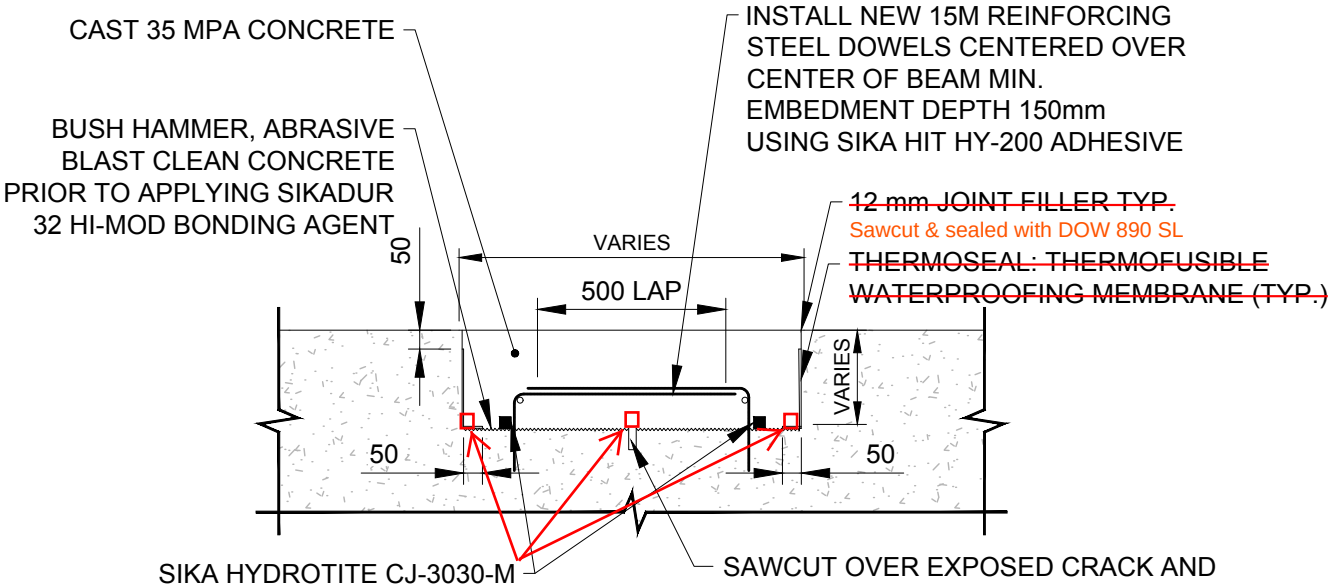

B - DETAIL 1:20
REPAIRED AREA

NOTES:
1. JOINT SEAL, REINFORCING STEEL AND CONCRETE IN STRUCTURE SHALL FOLLOW SPECIFICATIONS ON DWG 5166-00-S-302
2. CONCRETE FINISH TO MATCH EXISTING SURROUNDING CONCRETE
3. CONCRETE COVER TO BE MIN. 50 mm +/- 10 mm

PLOT DATE: 7/30/2018 2:14:11 PM
SAVE DATE: 7/26/2018 10:16:32 AM SAVED BY: RIMANDOR
DWG PATH: \\s-atc-fs-01\projects\2017\5166\00_joint_repair\engineering\05.00_design\working_ dwgs\300_ structural\rainbow plaza joint repair\5166-00-s-302.dwg

Associated Engineering

AE PROJECT No.	2017-5166
SCALE	AS SHOWN
APPROVED	G. BURN
DATE	20180730
REV	0
DESCRIPTION	ISSUED FOR CONSTRUCTION

RAINBOW BRIDGE PLAZA LEAK

NIAGARA FALLS BRIDGE COMMISSION

STRUCTURAL

DWG No. 5166-SK01